



Republic of the Philippines  
**DON HONORIO VENTURA STATE UNIVERSITY**  
Villa de Bacolor, Pampanga

**SUPPLEMENTAL/BID BULLETIN NO. 2**

**“SUPPLY AND DELIVERY OF TABLES AND CABINETS TO BE USED AT THE IT AND COMPUTER ENGINEERING BUILDING, HEALTH AND SCIENCES BUILDING, IRTPC 1 EXTENSION BUILDING, AND CCS BUILDING AT MAIN CAMPUS AND ACADEMIC BUILDING AT DHVSU LUBAO CAMPUS”**

**ABC: P 5,352,450.00**

This bid bulletin dated September 23, 2024 is issued to clarify, modify or amend items in the Bidding Documents. This shall form an integral part of the Bid Documents.


- Furniture details and perspectives are attached in this document.

**Important Reminders:**

- **Dropping of Bids** will be at the Bids and Awards Committee Office, 2<sup>nd</sup> Floor University Food Center (UFC), DHVSU Main Campus, Bacolor, Pampanga. As a precautionary measure and to give time for disinfection of the submitted bids, submission at least two (2) days before the opening is encouraged.
- Please use attached form to state compliance on the modifications/amendments on the Technical Specification.

Please be guided accordingly.

  
**BANJO P. SAMSON**  
Head, BAC Secretariat




  
**RANIE B. CANLAS, DIT**  
Chairman, Bids and Awards Committee

<b>Description</b>	<b>Comply</b>	<b>Not Comply</b>
Furniture details and perspectives		



\*Note: This shall form an integral part of the Bid Documents must be included as part of Envelope 1.

**SCOPE OF WORKS:**


1. PROVISION OF STAFF TABLE CUBICLE L-TYPE (1.40M x 1.20M x 1.20M HIGH) 12 NOS. REQ'D.

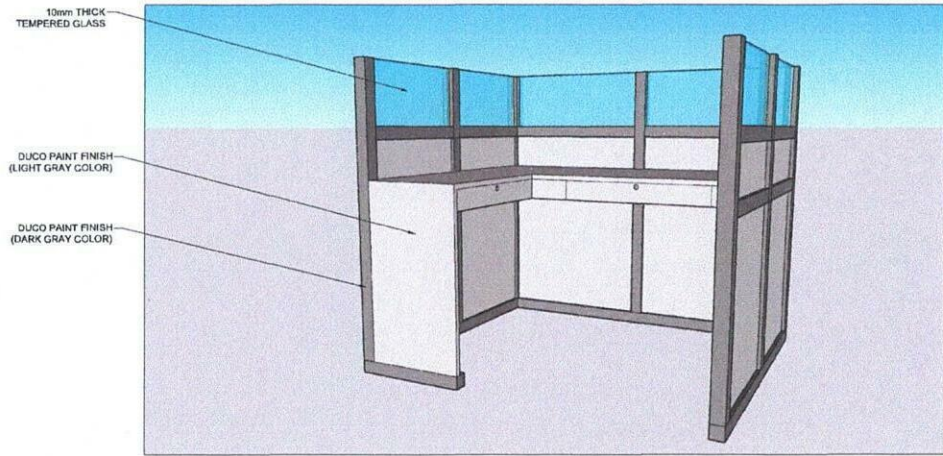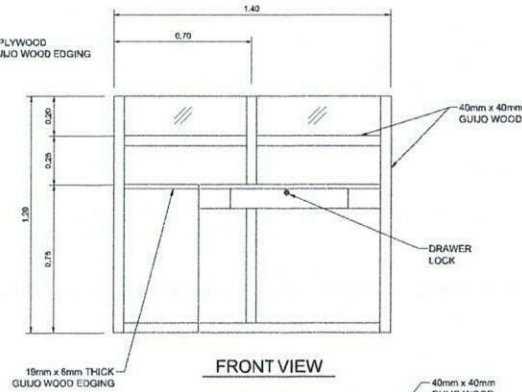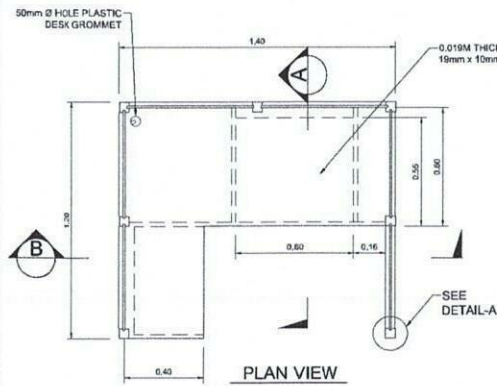


**PERSPECTIVE**

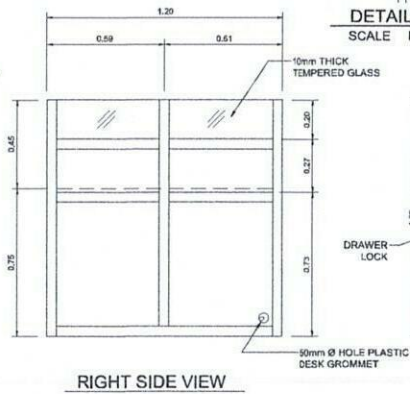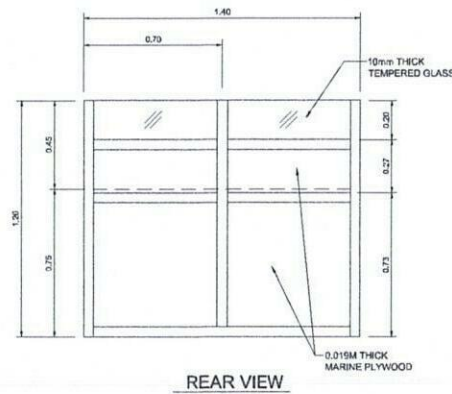

**DETAIL - A**  
SCALE NTS.

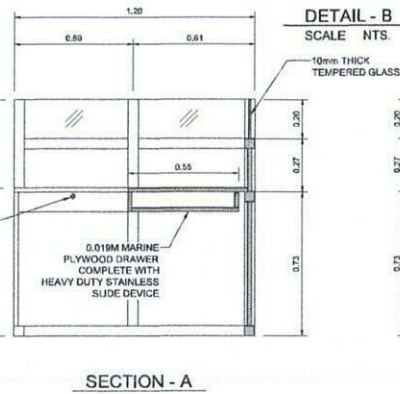

**DETAIL - B**  
SCALE NTS.

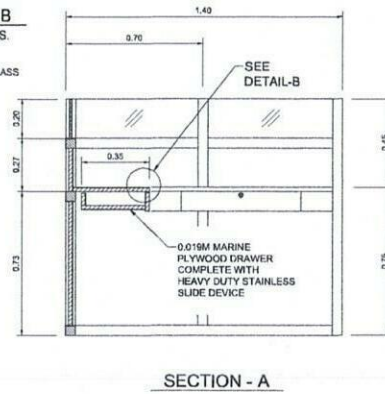

**A-01**  
01 01 SCALE  
**DETAIL OF TABLE/CUBICLE - 1**  
(12 NOS. REQUIRED)  
1:15 MTS.



PREPARED BY:  
DON HONORIO VENTURA STATE UNIVERSITY  
BACOLOR, PAMPANGA  
OFFICE OF PHYSICAL PLANT  
AND FACILITIES

ARCHITECT:

PRC NO:  
PROJECT TITLE:  
TIN NO:  
PTR NO:  
DATE:  
AT:  
LOCATION:  
PAMPANGA

RECOMMENDING APPROVAL:  
ENGR. ROWEL WAJE Ma.Ed  
CIC-DIRECTOR, O.P.P.F

APPROVED BY:  
ENRIQUE G. BAKING Ed.D  
SUC PRESIDENT III

SHEET CONTENT:  
AS SHOWN







CADD BY:  
R.V. MERCADO  
DATE / FILENAME:

SHEET NO:  
A-01  
01 10



**SCOPE OF WORKS:**

1. PROVISION OF HANGING CABINET - 2  
(2.4M x 0.40M HIGH x 0.45M DEPTH) (2 NOS. REQ'D.)

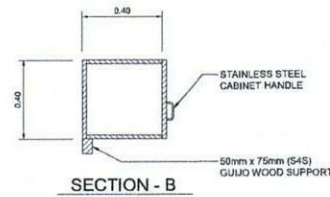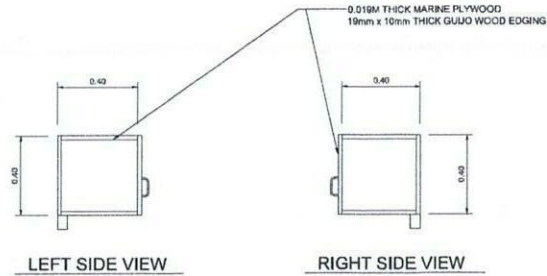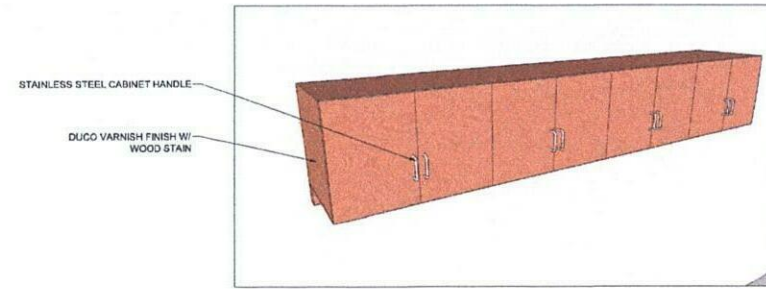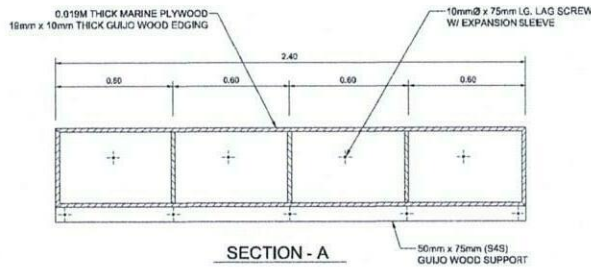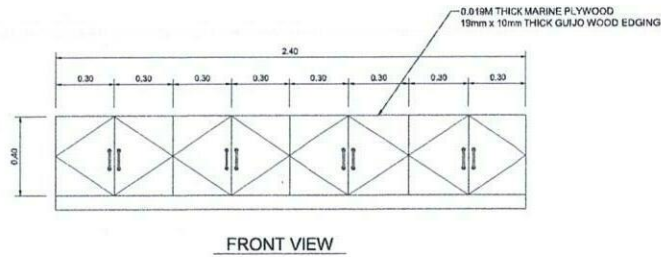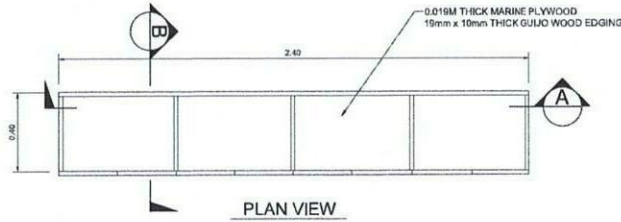

**A-02** **DETAIL OF HANGING CABINET**  
01 | 01 SCALE 1:15 MTS. (2 NOS. REQUIRED)



PREPARED BY:  
DON HONORIO VENTURA STATE UNIVERSITY  
BACOLOR, PAMPANGA  
OFFICE OF PHYSICAL PLANT  
AND FACILITIES

ARCHITECT:

PRC NO:  
TIN NO:  
PTR NO:  
DATE:  
AT:

PROJECT TITLE:  
Supply and Delivery of Tables and Cabinets to IT and Computer  
Engineering Building, Health and Sciences Building, IRTPC 1 Extension  
Building and CCS Building at DHVSU Main Campus and Academic  
Building at DHVSU Lubao Campus  
LOCATION:  
PAMPANGA

RECOMMENDING APPROVAL:  
**ENGR. ROWEL WAJE Ma.Ed**  
OIC-DIRECTOR, O.P.F.F

APPROVED BY:  
**ENRIQUE G. BAKING Ed.D**  
SUC PRESIDENT III







SHEET CONTENT:  
AS SHOWN

CADD BY:  
R.V. MERCADO  
DATE / FILENAME:

SHEET NO:  
**A-02**  
02 | 10

**SCOPE OF WORKS:**

1. PROVISION OF STAND CABINET, (9 NOS. REQUIRED)

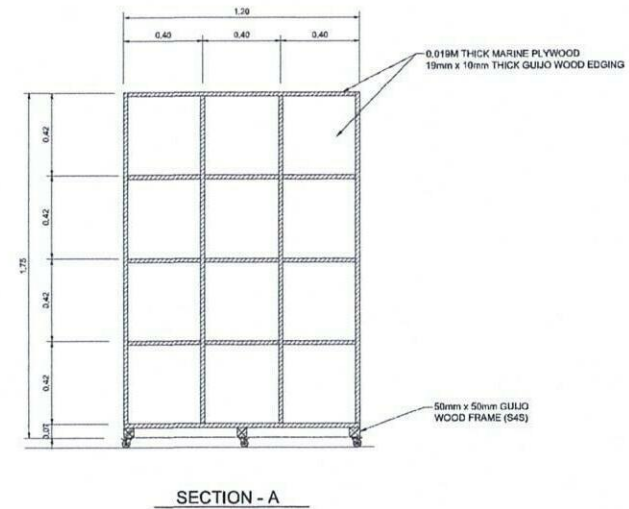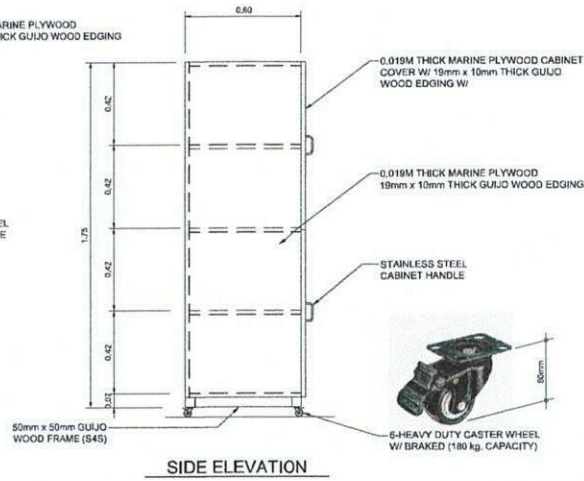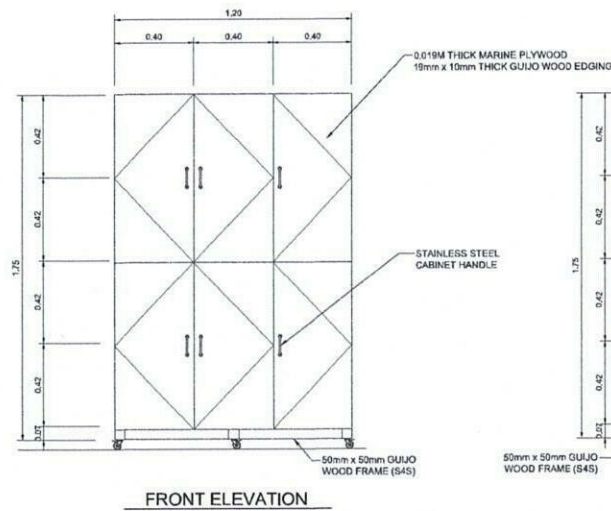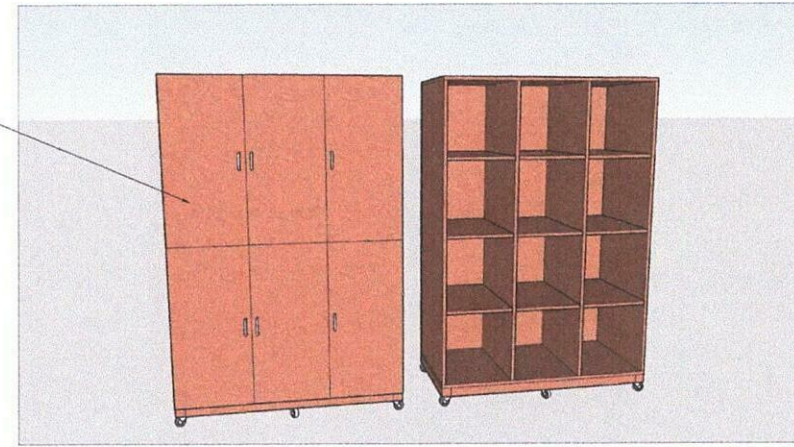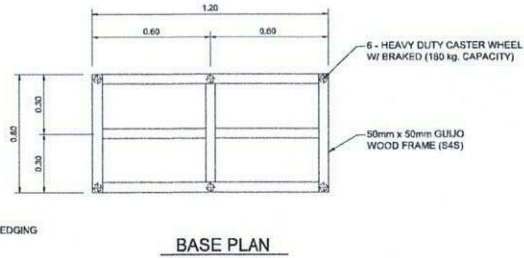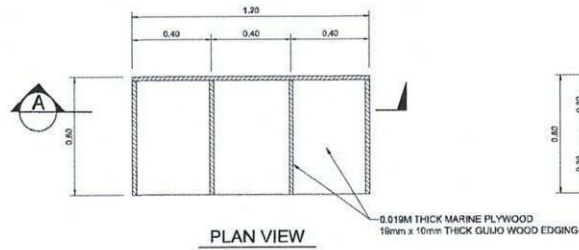


**A-03**  
01 01  
**DETAIL OF STAND CABINET**  
SCALE 1 : 15 MTS  
**(9 NOS. REQUIRED)**

	PREPARED BY: DON HONORIO VENTURA STATE UNIVERSITY BACOLOR, PAMPANGA  OFFICE OF PHYSICAL PLANT AND FACILITIES	ARCHITECT :	PRC NO: TIN NO: PTR NO: DATE: AT:	PROJECT TITLE: Supply and Delivery of Tables and Cabinets to IT and Computer Engineering Building, Health and Sciences Building, IRTPC 1 Extension Building and CCS Building at DHVSU Main Campus and Academic Building at DHVSU Lubao Campus  LOCATION: PAMPANGA	RECOMMENDING APPROVAL:  ENGR. ROWEL WAJE Ma.Ed OIC-DIRECTOR, O.P.F.F.	APPROVED BY:  ENRIQUE G. BAKING Ed.D SUC PRESIDENT III	SHEET CONTENT:  AS SHOWN	CADD BY: R.V. MERCADO DATE / FILENAME:	SHEET NO: A-03 03 10




# SCOPE OF WORKS:


1. PROVISION OF 3 SEATER COMPUTER TABLE (2.40 x 0.70M) 40 NOS. REQUIRED

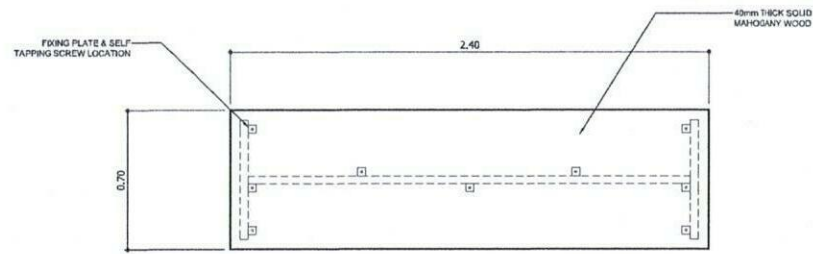


TOP VIEW

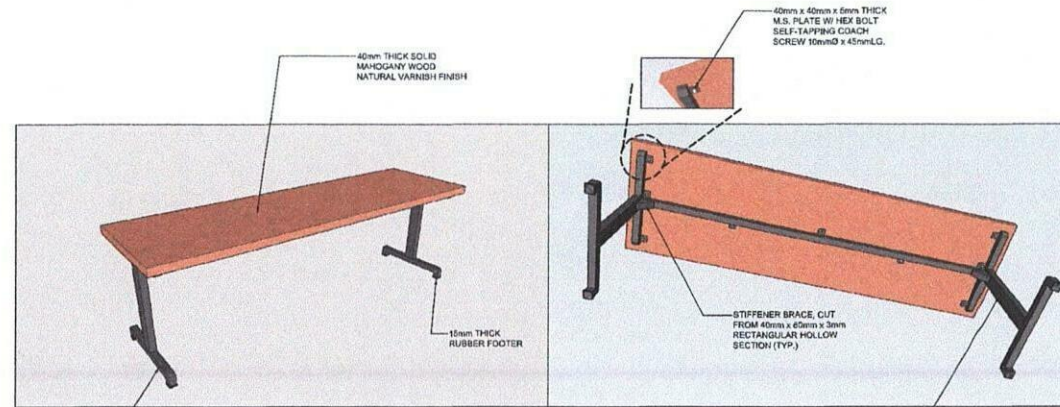

PERSPECTIVE VIEW

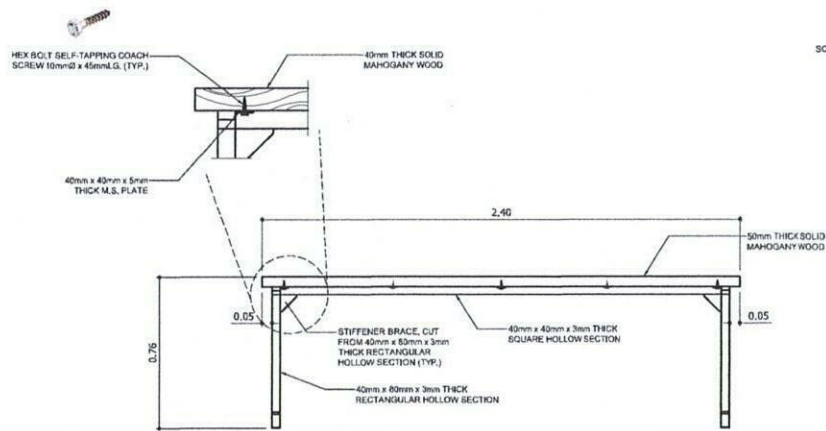

FRONT VIEW

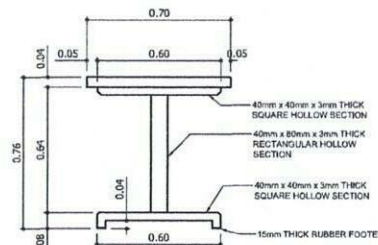

SIDE VIEW

A-4  
01 | 01

## DETAIL OF COMPUTER TABLE

SCALE

40 NOS. REQUIRED

1 : 15 MTS.



PREPARED BY:  
DON HONORIO VENTURA STATE UNIVERSITY  
BACOLOR, PAMPANGA  
OFFICE OF PHYSICAL PLANT  
AND FACILITIES

ARCHITECT

PRC NO:  
TIN NO:  
PTR NO:  
DATE:  
AT:

PROJECT TITLE:  
Supply and Delivery of Tables and Cabinets to IT and Computer Engineering Building, Health & Science Building, IRTPC 1 Extension Building and CCS Building at DHVSU Main Campus and Academic Building at DHVSU Lubao Campus  
LOCATION:  
BACOLOR, PAMPANGA

RECOMMENDING APPROVAL:  
ENGR. ROWEL D. WAJE Ma.Ed  
OIC DIRECTOR, O.P.P.F

APPROVED BY:  
ENRIQUE G. BAKING Ed.D  
SUC PRESIDENT III


SHEET CONTENT:  
AS SHOWN

CADD BY:  
R.V. MERCADO  
DATE / FILENAME:


SHEET NO:  
A-4  
05/10

**SCOPE OF WORKS:**

1. PROVISION OF FABRICATED WOODEN CHAIR (3 NOS. REQUIRED)

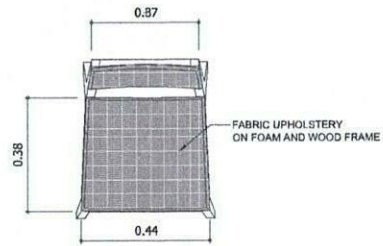


**PLAN VIEW**

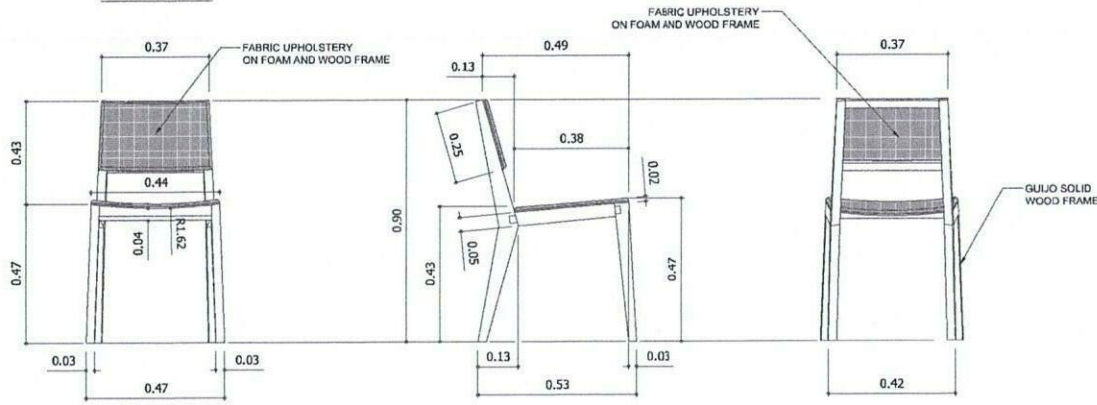

**FRONT VIEW**

**SIDE VIEW**

**REAR VIEW**

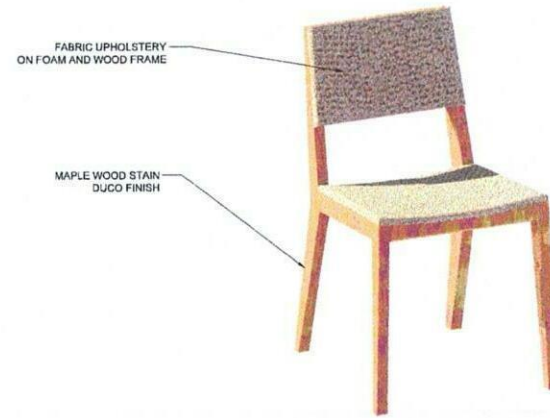

**PERSPECTIVE**

A-05  
01 | 01

**DETAIL OF FABRICATED WOODEN CHAIR**

SCALE

1 : 10 MTS.

(3 NOS. REQUIRED)



PREPARED BY:  
DON HONORIO VENTURA STATE UNIVERSITY  
BACOLOR, PAMPANGA  
  
OFFICE OF PHYSICAL PLANT  
AND FACILITIES

ARCHITECT :

PRC NO:  
TIN NO:  
PTR NO:  
DATE:  
AT:

PROJECT TITLE:  
Supply and Delivery of Tables and Cabinets to IT and Computer  
Engineering Building, Health and Sciences Building, IRTPC 1 Extension  
Building and CCS Building at DHVSU Main Campus and Academic  
Building at DHVSU Lubao Campus  
  
LOCATION:  
PAMPANGA

RECOMMENDING APPROVAL:  
  
ENGR. ROWEL WAJE Ma.Ed  
OIC-DIRECTOR, O.P.P.F.

APPROVED BY:  
  
ENRIQUE G. BAKING Ed.D  
SUC PRESIDENT III

SHEET CONTENT:  
  
AS SHOWN









CADD BY:  
R.V. MERCADO  
DATE / FILENAME:

SHEET NO:  
  
A-05  
05 | 10



**SCOPE OF WORKS:**

1. PROVISION OF FACULTY TABLE (55 NOS. REQD.)

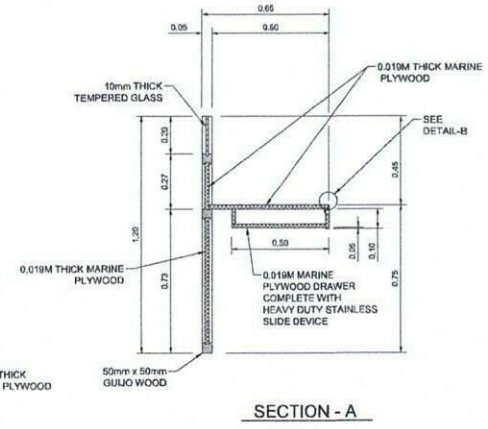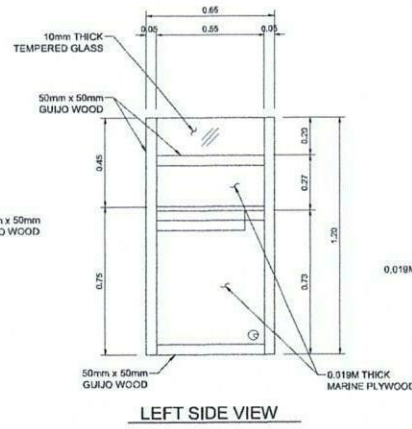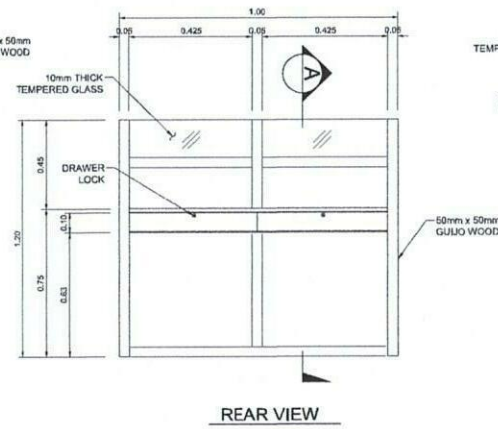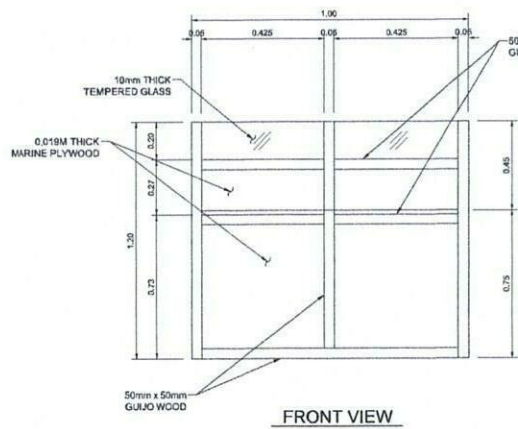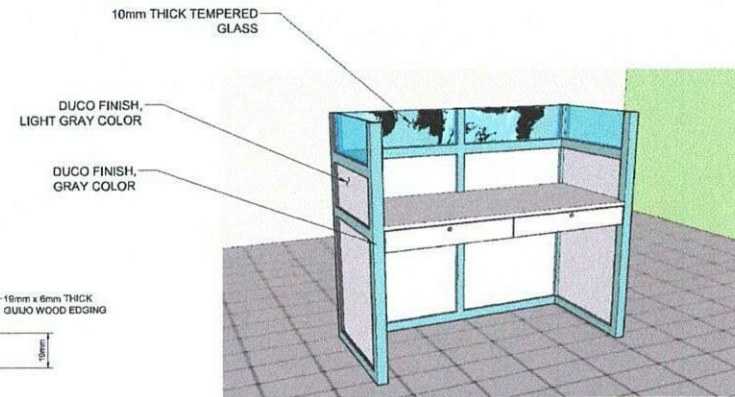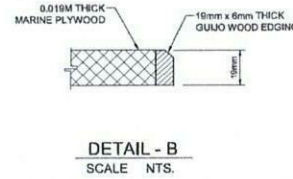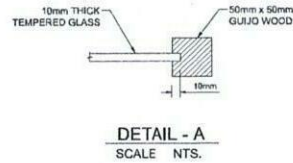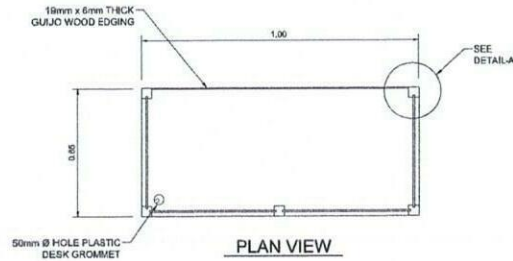

**A-06**  
01 01  
**DETAIL OF FACULTY TABLE**  
SCALE 1 : 15 MTS  
**(55 NOS. REQUIRED)**



PREPARED BY:  
DON HONORIO VENTURA STATE UNIVERSITY  
BACOLOR, PAMPANGA  
**OFFICE OF PHYSICAL PLANT  
AND FACILITIES**

ARCHITECT :

PRC NO:  
TIN NO:  
PTR NO:  
DATE:  
AT:

PROJECT TITLE:  
**Supply and Delivery of Tables and Cabinets to IT and Computer  
Engineering Building, Health and Sciences Building, IRTPC 1 Extension  
Building and CCS Building at DHVSU Main Campus and Academic  
Building at DHVSU Lubao Campus**  
LOCATION:  
PAMPANGA

RECOMMENDING APPROVAL:  
**ENGR. ROWEL WAJE M.A.Ed**  
DIC-DIRECTOR, O.P.F.F.

APPROVED BY:  
**ENRIQUE G. BAKING Ed.D**  
SUC PRESIDENT III

SHEET CONTENT:  
AS SHOWN


CADD BY:  
R.V. MERCADO  
DATE / FILENAME:

SHEET NO:  
**A-06**  
06 10



**SCOPE OF WORKS:**

1. PROVISION OF CABINET W/ GLASS (10 NOS. REQD.)

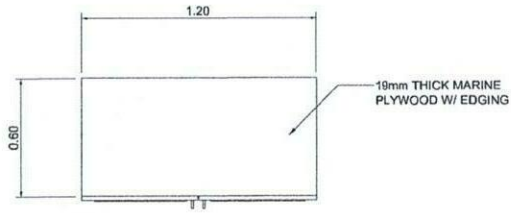


**PLAN VIEW**


DUCO PAINT WHITE FINISH

STAINLESS CABINET HANDLE


6mm THICK CLEAR GLASS

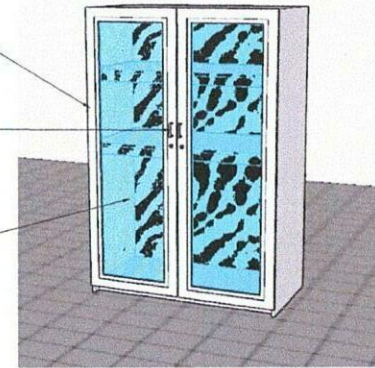


**PERSPECTIVE**

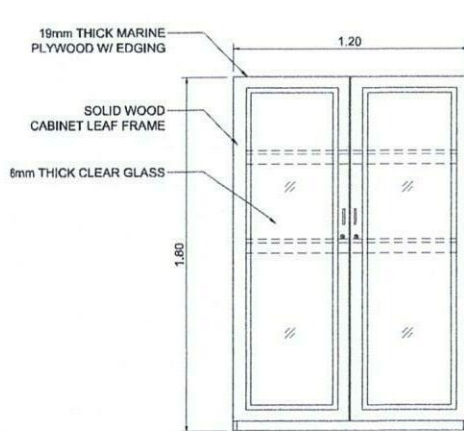


**FRONT VIEW**

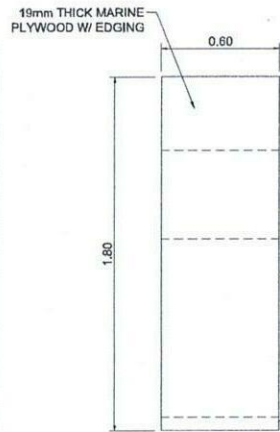

**SIDE VIEW**

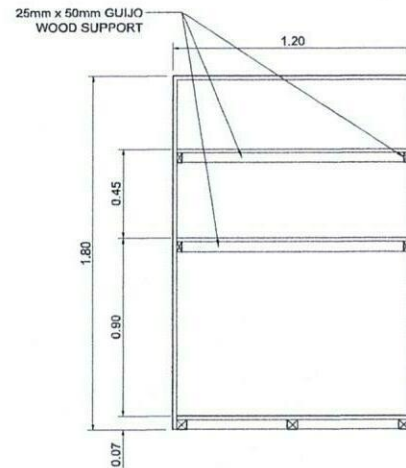

**LONGITUDINAL SECTION**

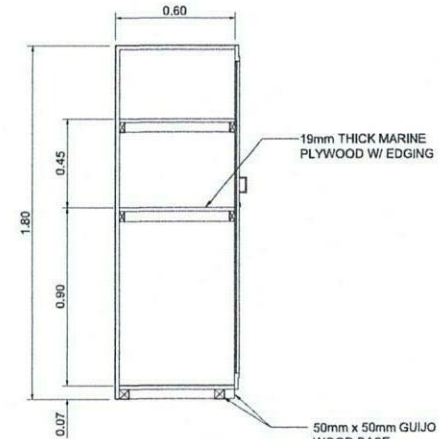

**CROSS SECTION**

A-07  
01 01

**CABINET DETAIL**

SCALE 1:15 MTS.

(10 NOS. REQUIRED)



PREPARED BY:  
DON HONORIO VENTURA STATE UNIVERSITY  
BACOLOR, PAMPANGA  
  
OFFICE OF PHYSICAL PLANT  
AND FACILITIES

ARCHITECT :

PRC NO:  
TIN NO:  
PTR NO:  
DATE:  
AT:  
  
PROJECT TITLE:  
Supply and Delivery of Tables and Cabinets to IT and Computer Engineering Building, Health and Sciences Building, IRTPC 1 Extension Building and CCS Building at DHVSU Main Campus and Academic Building at DHVSU Lubao Campus  
  
LOCATION:  
PAMPANGA

RECOMMENDING APPROVAL:  
  
ENGR. ROWEL WAJE Ma.Ed  
OIC-DIRECTOR, O.P.P.F.

APPROVED BY:  
  
ENRIQUE G. BAKING Ed.D  
SUC PRESIDENT III


SHEET CONTENT:  
AS SHOWN

CADD BY:  
R.V. MERCADO  
DATE / FILENAME:


SHEET NO:  
A-07  
07 10

**SCOPE OF WORKS:**


1. PROVISION OF TECHNICIAN TABLE (1 NOS. REQ'D.)

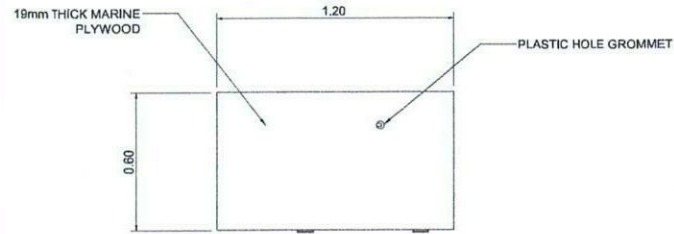


**PLAN VIEW**

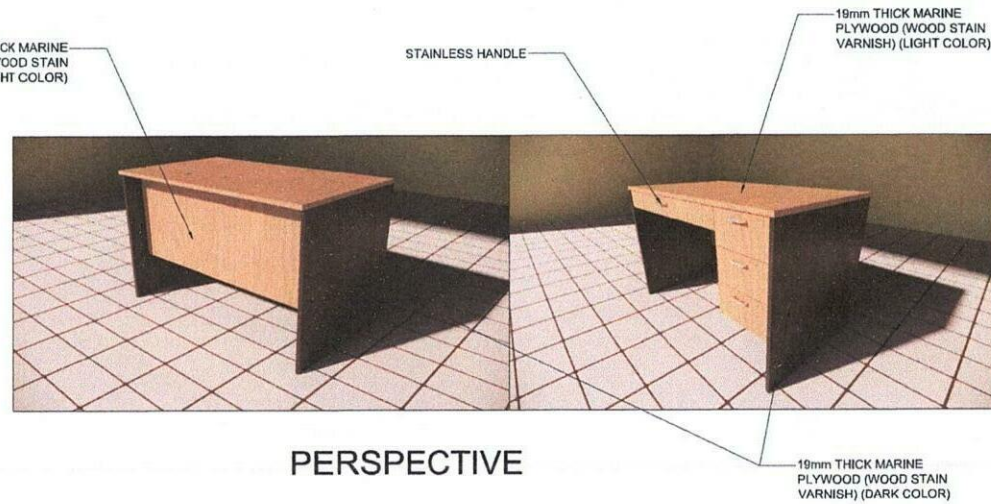


**PERSPECTIVE**

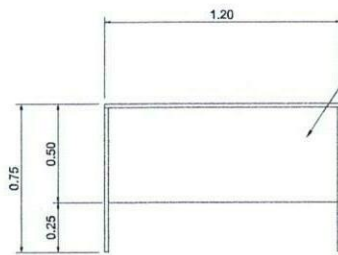


**FRONT VIEW**

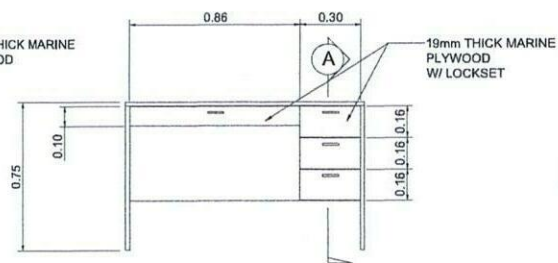

**REAR VIEW**

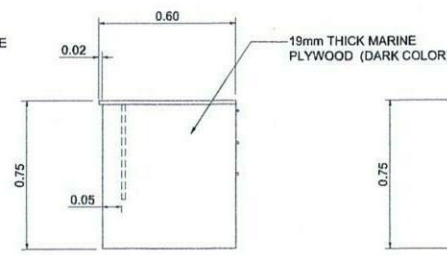

**SIDE VIEW**

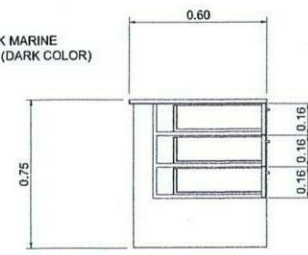

**SECTION-A**

A-08  
01 01

**TECHNICIAN TABLE DETAIL**

SCALE 1:15 MTS.  
(1 NO. REQUIRED)



PREPARED BY:  
DON HONORIO VENTURA STATE UNIVERSITY  
BACOLOR PAMPANGA  
  
OFFICE OF PHYSICAL PLANT  
AND FACILITIES

ARCHITECT:

PROJECT TITLE:  
Supply and Delivery of Tables and Cabinets to IT and Computer  
Engineering Building, Health and Sciences Building, IRTPC 1 Extension  
Building and CCS Building at DHVSU Main Campus and Academic  
Building at DHVSU Lubao Campus  
  
LOCATION:  
PAMPANGA

RECOMMENDING APPROVAL:  
  
ENGR. ROWEL WAJE Ma.Ed  
OIC-DIRECTOR, O.P.P.F.

APPROVED BY:  
  
ENRIQUE G. BAKING Ed.D  
SUC PRESIDENT III

SHEET CONTENT:  
  
AS SHOWN


CADD BY:  
R.V. MERCADO  
DATE / FILENAME:

SHEET NO:  
  
A-08  
08 10




**SCOPE OF WORKS:**


**1. PROVISION OF COMPUTER TABLE (20 NOS. REQ'D.)**

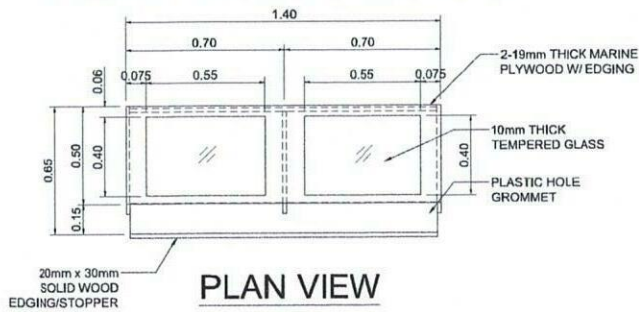


**PLAN VIEW**

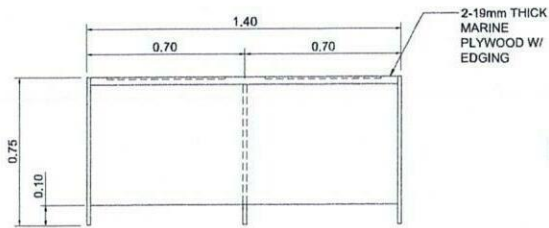


**FRONT VIEW**

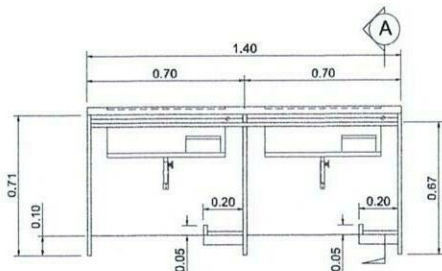

**REAR VIEW**

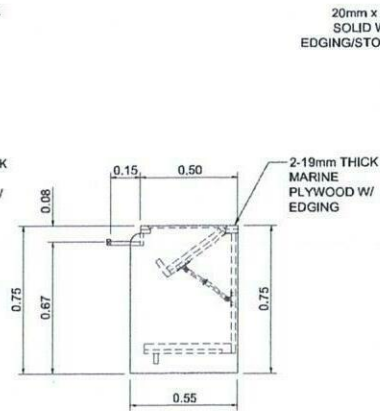

**REAR VIEW**

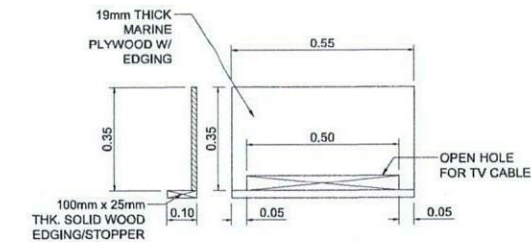

**MONITOR SADDLE DETAIL**


SCALE 1:10 MTS

20mm DIA. HOLE FOR CABLE ENTRY


DUCO VARNISH FINISH (DARK WOOD STAIN COLOR)



**PERSPECTIVE**

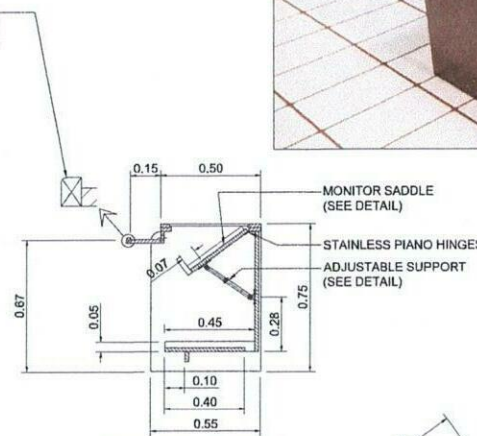

**REAR VIEW**

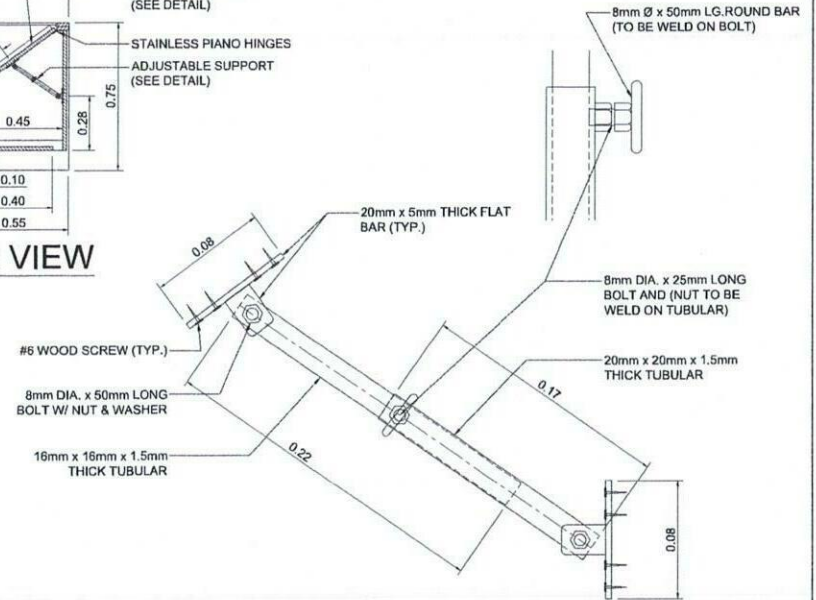

**ADJUSTABLE SUPPORT DETAIL**

SCALE N.T.S.

A-09  
01 01

**COMPUTER TABLE DETAIL**

SCALE (20 NO. REQUIRED) 1:15 MTS. (UNO.)



PREPARED BY:  
DON HONORIO VENTURA STATE UNIVERSITY  
BACOLOR, PAMPANGA  
OFFICE OF PHYSICAL PLANT  
AND FACILITIES

ARCHITECT:

PRC NO:  
TIN NO:  
PTR NO:  
DATE:  
AT:

PROJECT TITLE:  
Supply and Delivery of Tables and Cabinets to IT and Computer  
Engineering Building, Health and Sciences Building, IRTPC 1 Extension  
Building and CCS Building at DHVSU Main Campus and Academic  
Building at DHVSU Lubao Campus  
LOCATION:  
PAMPANGA

RECOMMENDING APPROVAL:  
ENGR. ROWEL WAJE Ma.Ed  
OIC-DIRECTOR, O.P.P.F.

APPROVED BY:  
ENRIQUE G. BAKING Ed.D  
SUC PRESIDENT III

SHEET CONTENT:  
AS SHOWN


CADD BY:  
R.V. MERCADO  
DATE / FILENAME:

SHEET NO:  
A-09  
09 10




**SCOPE OF WORKS:**


1. PROVISION OF HANGING CABINET (L 3.20M x W 0.40M x H 0.60M (2 NOS. REQ'D.))

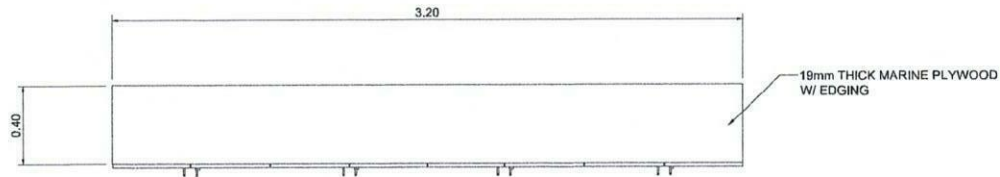

**PLAN VIEW**

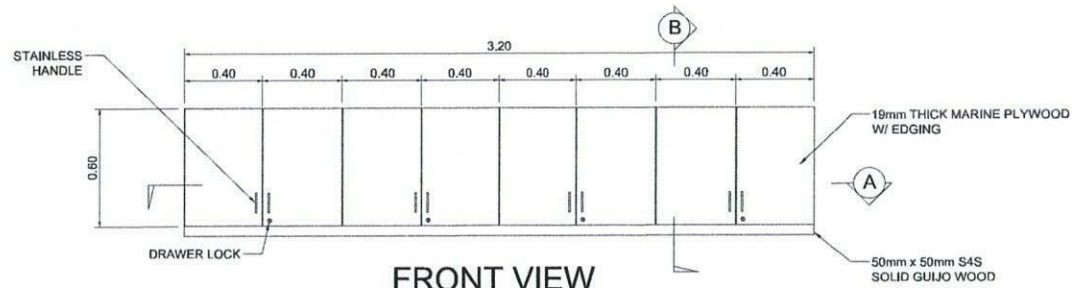


**FRONT VIEW**

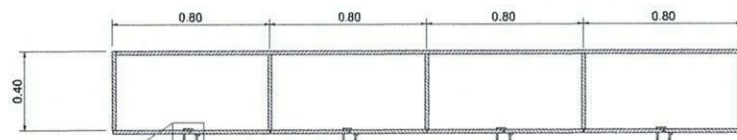


**SECTION-A**


50mm x 8mm THICK SOLID WOOD STOPPER

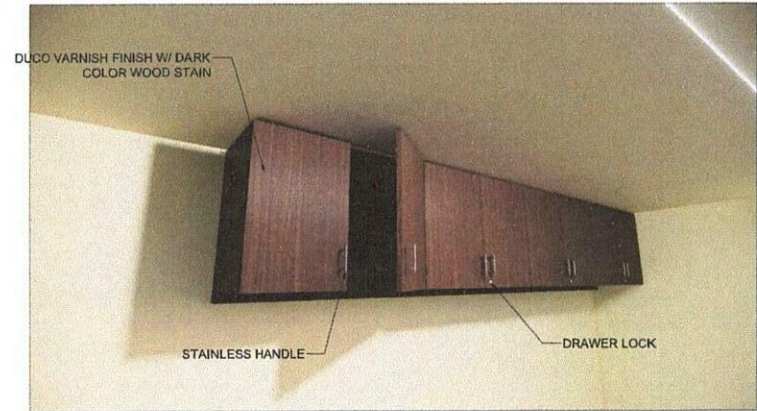

**PERSPECTIVE**

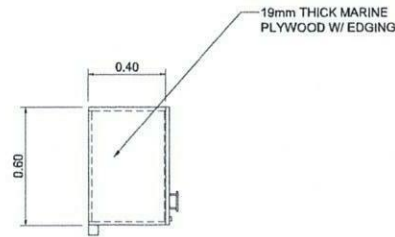

**SIDE VIEW**

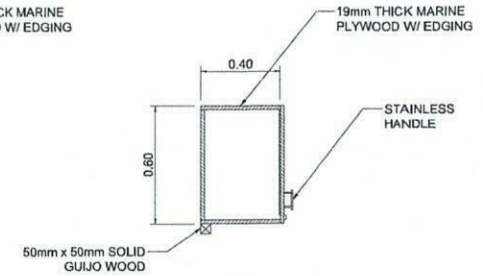

**SECTION-B**

A-10  
01 01

**HANGING CABINET DETAIL**

SCALE (2 NO. REQUIRED) 1:15 MTS.



PREPARED BY:  
DON HONORIO VENTURA STATE UNIVERSITY  
BACOLOR, PAMPANGA  
**OFFICE OF PHYSICAL PLANT  
AND FACILITIES**

ARCHITECT:

PROJECT TITLE:  
Supply and Delivery of Tables and Cabinets to IT and Computer Engineering Building, Health and Sciences Building, IRTPC 1 Extension Building and CGS Building at DHVSU Main Campus and Academic Building at DHVSU Lubao Campus  
LOCATION: PAMPANGA


RECOMMENDING APPROVAL:  
**ENGR. ROWEL WAJE Ma.Ed**  
OIC-DIRECTOR, O.P.P.F.

APPROVED BY:  
**ENRIQUE G. BAKING Ed.D**  
SUC PRESIDENT III

SHEET CONTENT:  
AS SHOWN


CADD BY:  
R.V. MERCADO  
DATE / FILENAME:

SHEET NO:  
**A-10**  
10/10

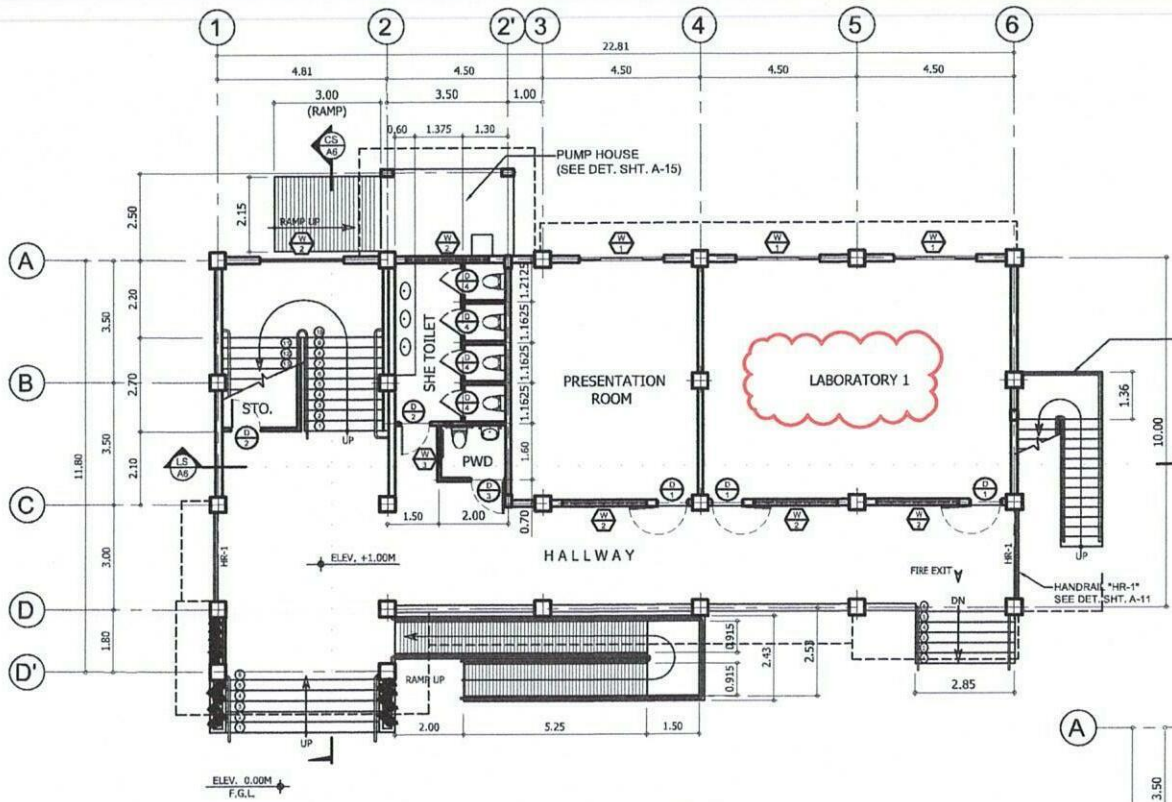


**A-1**  
01 02  
SCALE  
**GROUND FLOOR PLAN**  
1 : 100 MTS.

**LEGEND:**

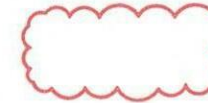

**DELIVERY LOCATION**

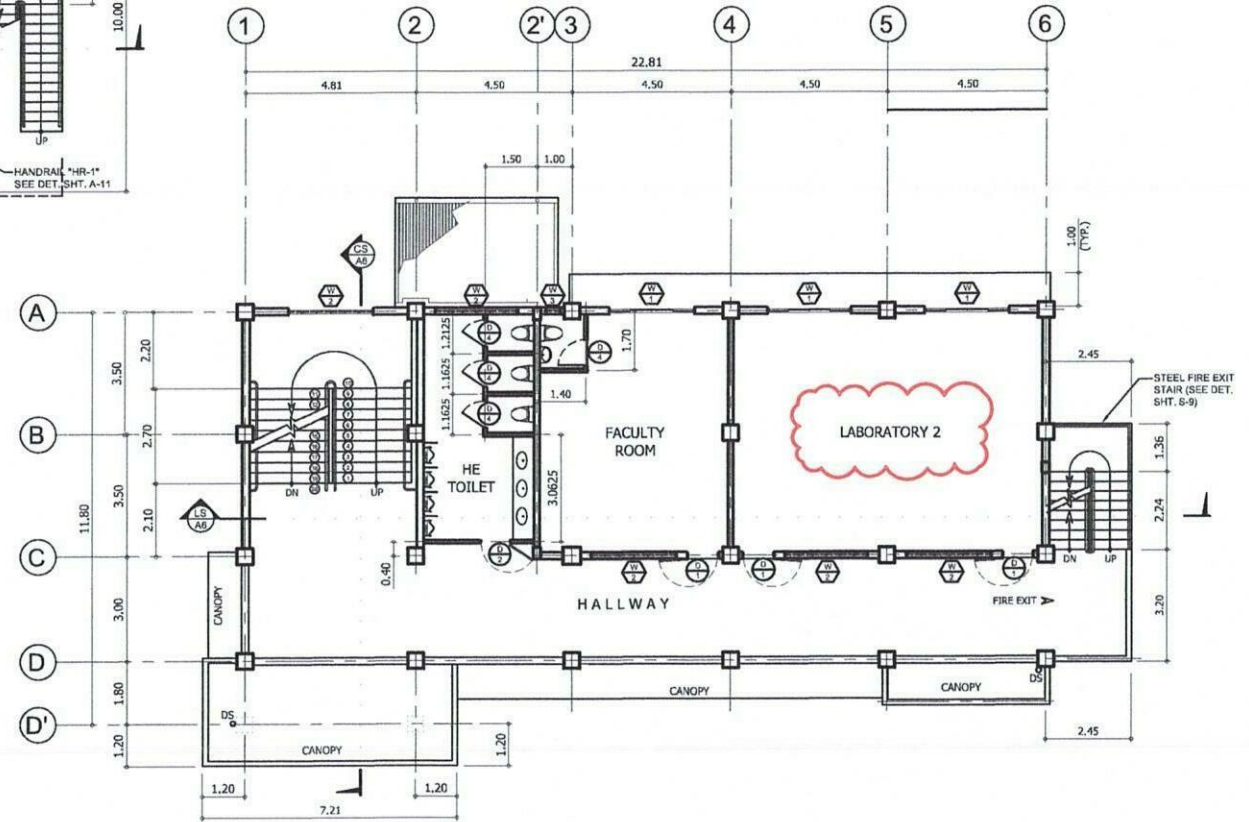

**A-1**  
02 02  
SCALE  
**SECOND FLOOR PLAN**  
1 : 100 MTS.



PREPARED BY:  
DON HONORIO VENTURA STATE UNIVERSITY  
BACOLOR, PAMPANGA  
OFFICE OF PHYSICAL PLANT  
AND FACILITIES

ARCHITECT:

PRC NO:  
TIN NO:  
PTR NO:  
DATE:  
AT:

PROJECT TITLE:  
**I.T. & COMPUTER  
ENGINEERING BUILDING**  
LOCATION: BACOLOR, PAMPANGA

RECOMMENDING APPROVAL:  
**ENGR. ROWEL WAJE Ma.Ed**  
OIC-DIRECTOR, O.P.P.F


APPROVED BY:  
**ENRIQUE G. BAKING Ed.D**  
SUC PRESIDENT III

SHEET CONTENT:  
AS SHOWN


CADD BY:  
R.V. MERCADO  
DATE / FILENAME:

SHEET NO.  
**A-1**  
01 02



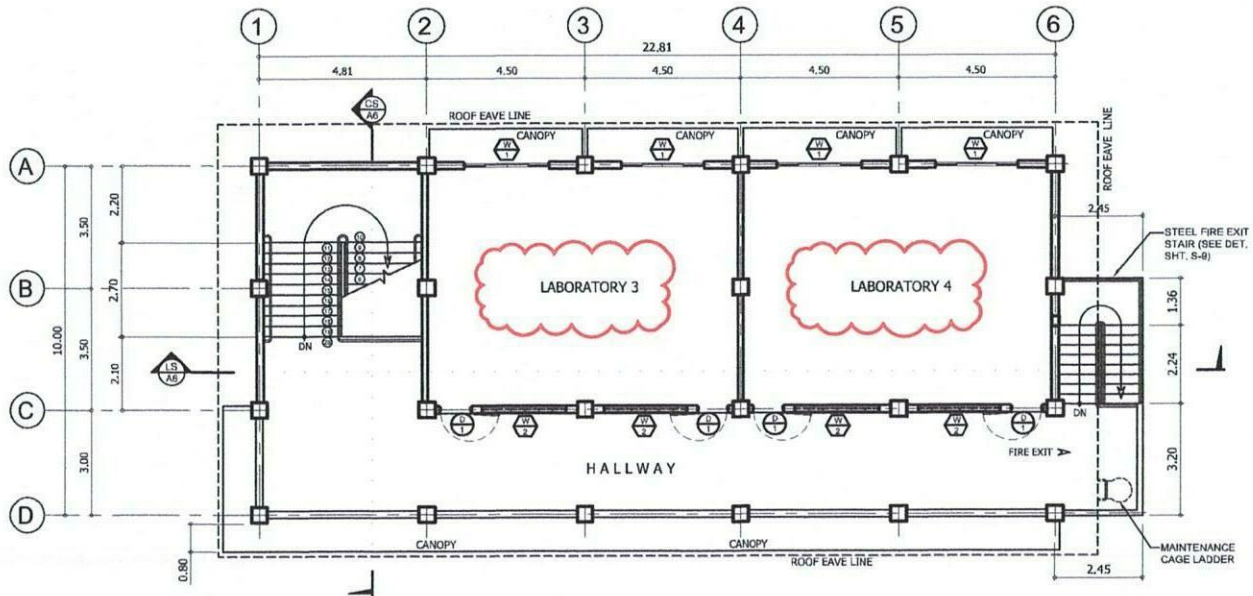


**A-2**  
01 02  
**THIRD FLOOR PLAN**  
SCALE 1 : 100 MTS.

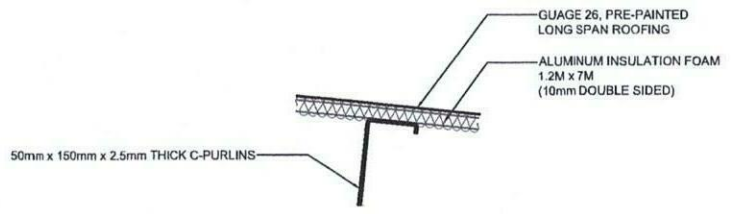

**A-4**  
03 03  
**ROOF INSULATION DETAIL**  
SCALE N.T.S.

**LEGEND:**  
 **DELIVERY LOCATION**

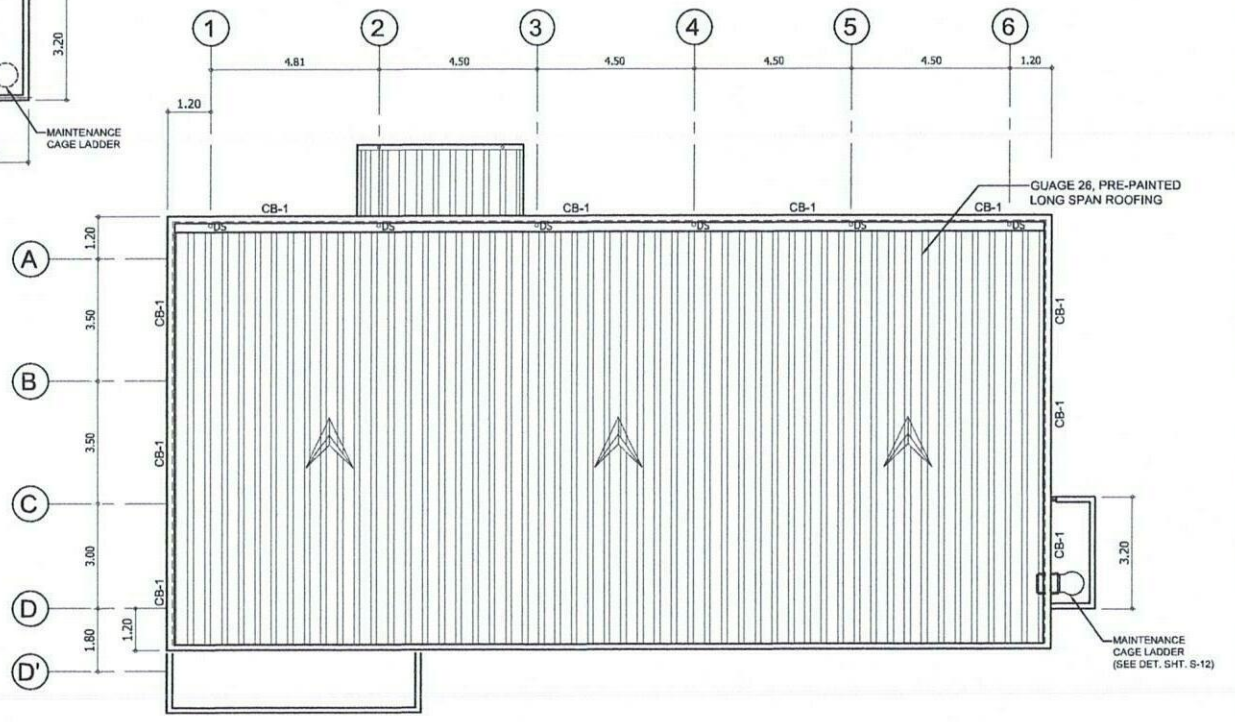


**A-2**  
02 03  
**ROOF PLAN**  
SCALE 1 : 100 MTS.



PREPARED BY: DON HONORIO VENTURA STATE UNIVERSITY BACOLOR, PAMPANGA  OFFICE OF PHYSICAL PLANT AND FACILITIES	APPROVED BY:	PRC NO: TRN NO: PTR NO: DATE: AT:	PROJECT TITLE:  <b>I.T. &amp; COMPUTER ENGINEERING BUILDING</b>	RECOMMENDING APPROVAL:  <b>ENGR. ROWEL WAJE Ma.Ed</b> <small>OIC-DIRECTOR, C.P.P.F</small>	APPROVED BY:  <b>ENRIQUE G. BAKING Ed.D</b> <small>SUC PRESIDENT III</small>	SHEET CONTENT:  AS SHOWN	CADD BY: R.V. MERCADO DATE / FILENAME:	SHEET NO:  <b>A-2</b> <b>02/02</b>
		LOCATION: BACOLOR, PAMPANGA	ENGR. ROWEL WAJE Ma.Ed <small>OIC-DIRECTOR, C.P.P.F</small>	ENRIQUE G. BAKING Ed.D <small>SUC PRESIDENT III</small>	AS SHOWN	R.V. MERCADO DATE / FILENAME:	<b>A-2</b> <b>02/02</b>	



**LEGEND:**

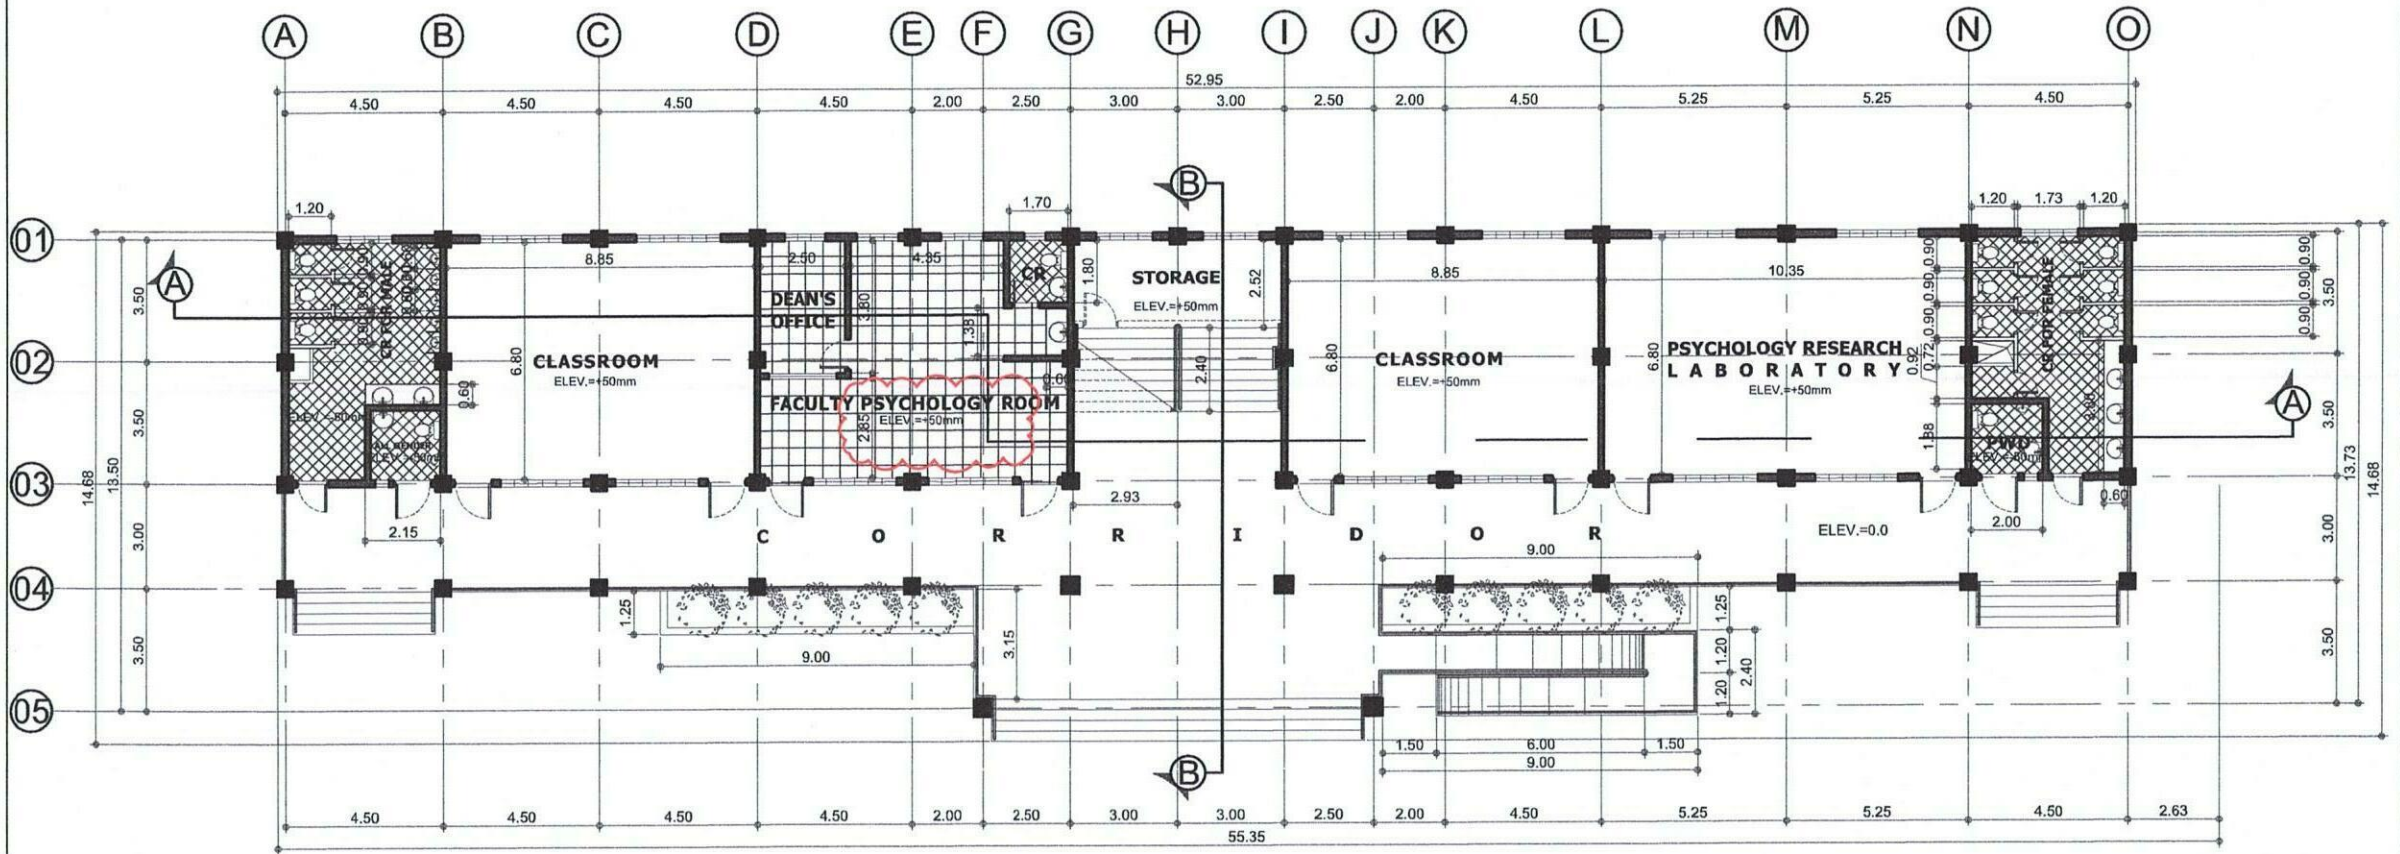


**A-01 GROUND FLOOR PLAN**  
 SCALE 1:100 MTS.


	PREPARED BY:	ARCHITECT:	PRC NO:	PROJECT TITLE:	RECOMMENDING APPROVAL:	APPROVED BY:	SHEET CONTENT:	CADD BY:	SHEET NO.
	DON HONORIO VENTURA STATE UNIVERSITY BACOLOR, PAMPANGA  OFFICE OF PHYSICAL PLANT AND FACILITIES			TRN NO: PTR NO: DATE: AT:	<b>HEALTH &amp; SCIENCE BUILDING</b>  LOCATION: BACOLOR, PAMPANGA	ENGR. ROWEL WAJE Ma.Ed OIC-DIRECTOR, O.P.P.F	ENRIQUE G. BAKING Ed.D SUC PRESIDENT III	AS SHOWN	R.V. MERCADO DATE / FILENAME:




**LEGEND:**  
 DELIVERY LOCATION

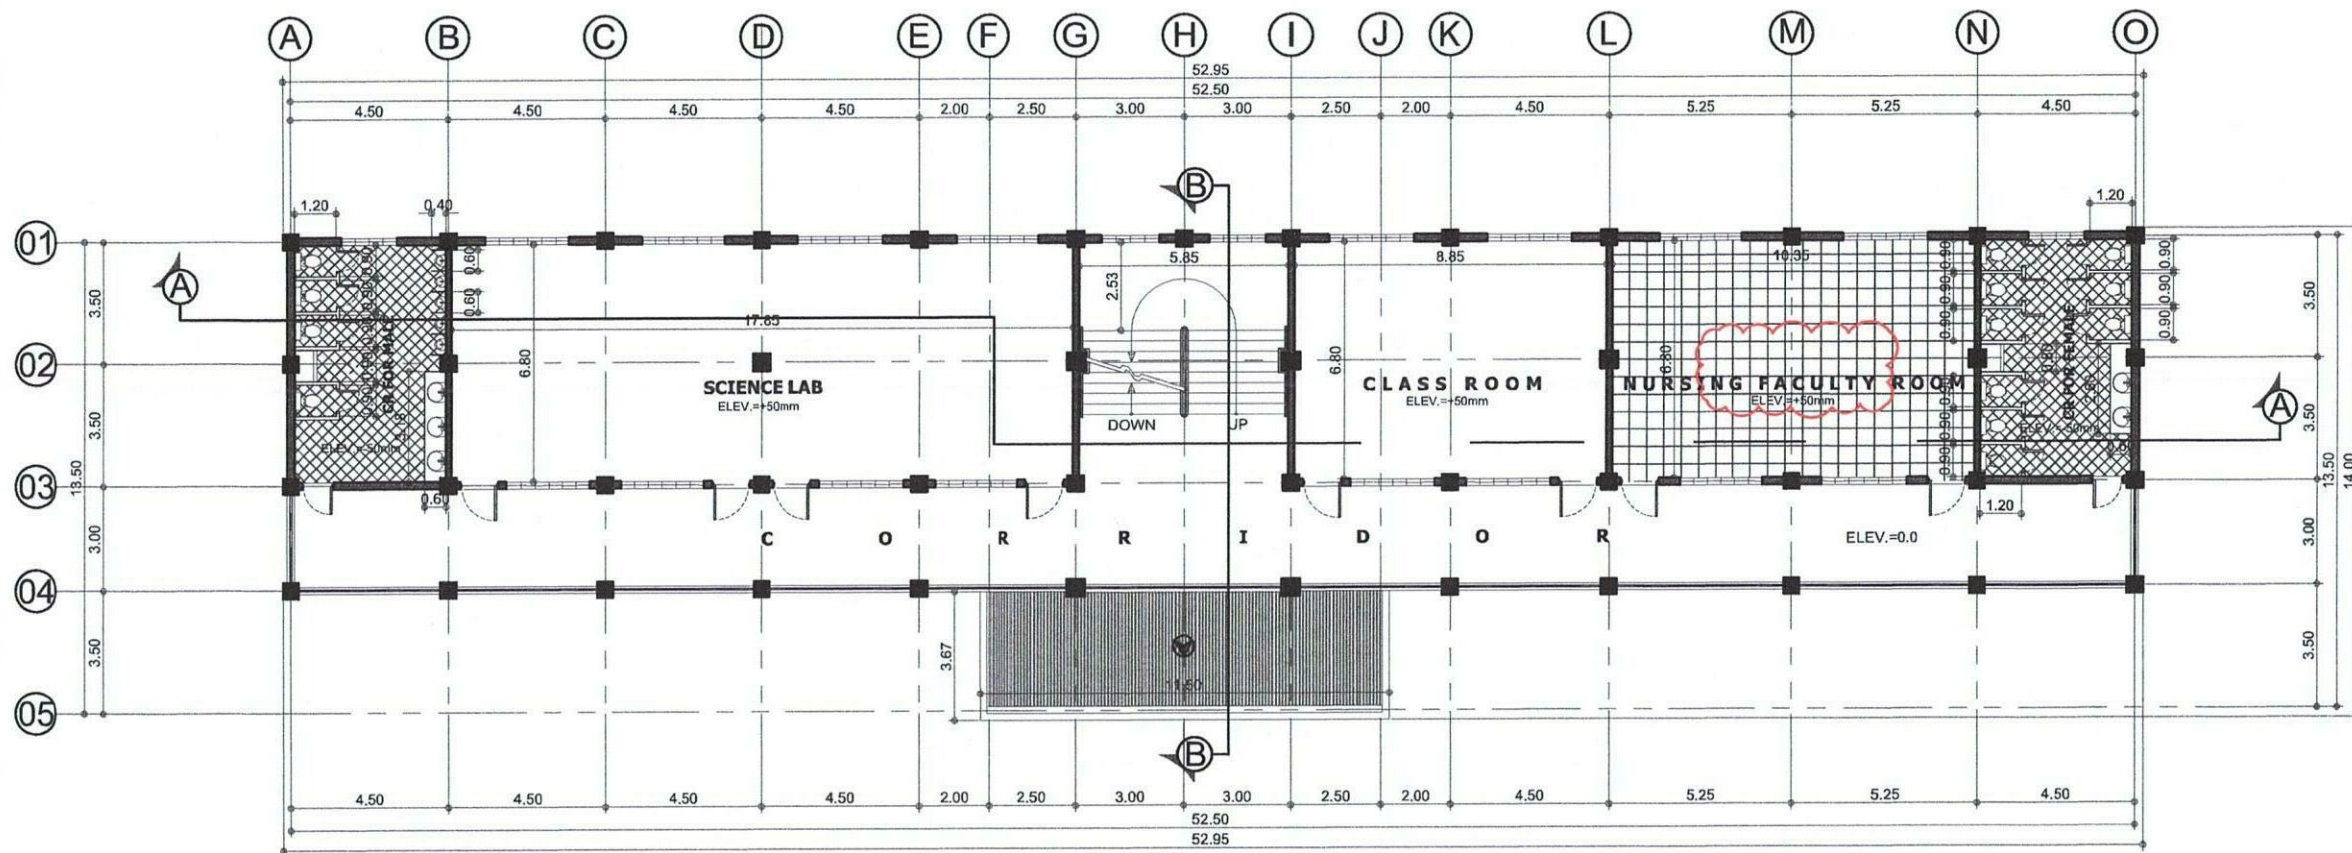

**A-02 SECOND FLOOR PLAN**  
 01/01 SCALE 1:100 MTS.

	PREPARED BY:	ARCHITECT:	PRC NO:	PROJECT TITLE:	RECOMMENDING APPROVAL:	APPROVED BY:	SHEET CONTENT:	CADD BY:	SHEET NO.:
	DON HONORIO VENTURA STATE UNIVERSITY BACOLOR, PAMPANGA  OFFICE OF PHYSICAL PLANT AND FACILITIES			TIN NO: PTR NO: DATE: AT:	<b>HEALTH &amp; SCIENCE BUILDING</b>  LOCATION: BACOLOR, PAMPANGA	ENGR. ROWEL WAJE Ma.Ed OIC-DIRECTOR, C.P.P.F	ENRIQUE G. BAKING Ed.D SUC PRESIDENT III	AS SHOWN	R.V. MERCADO DATE / FILENAME:

**LEGEND:**  
 **DELIVERY LOCATION**

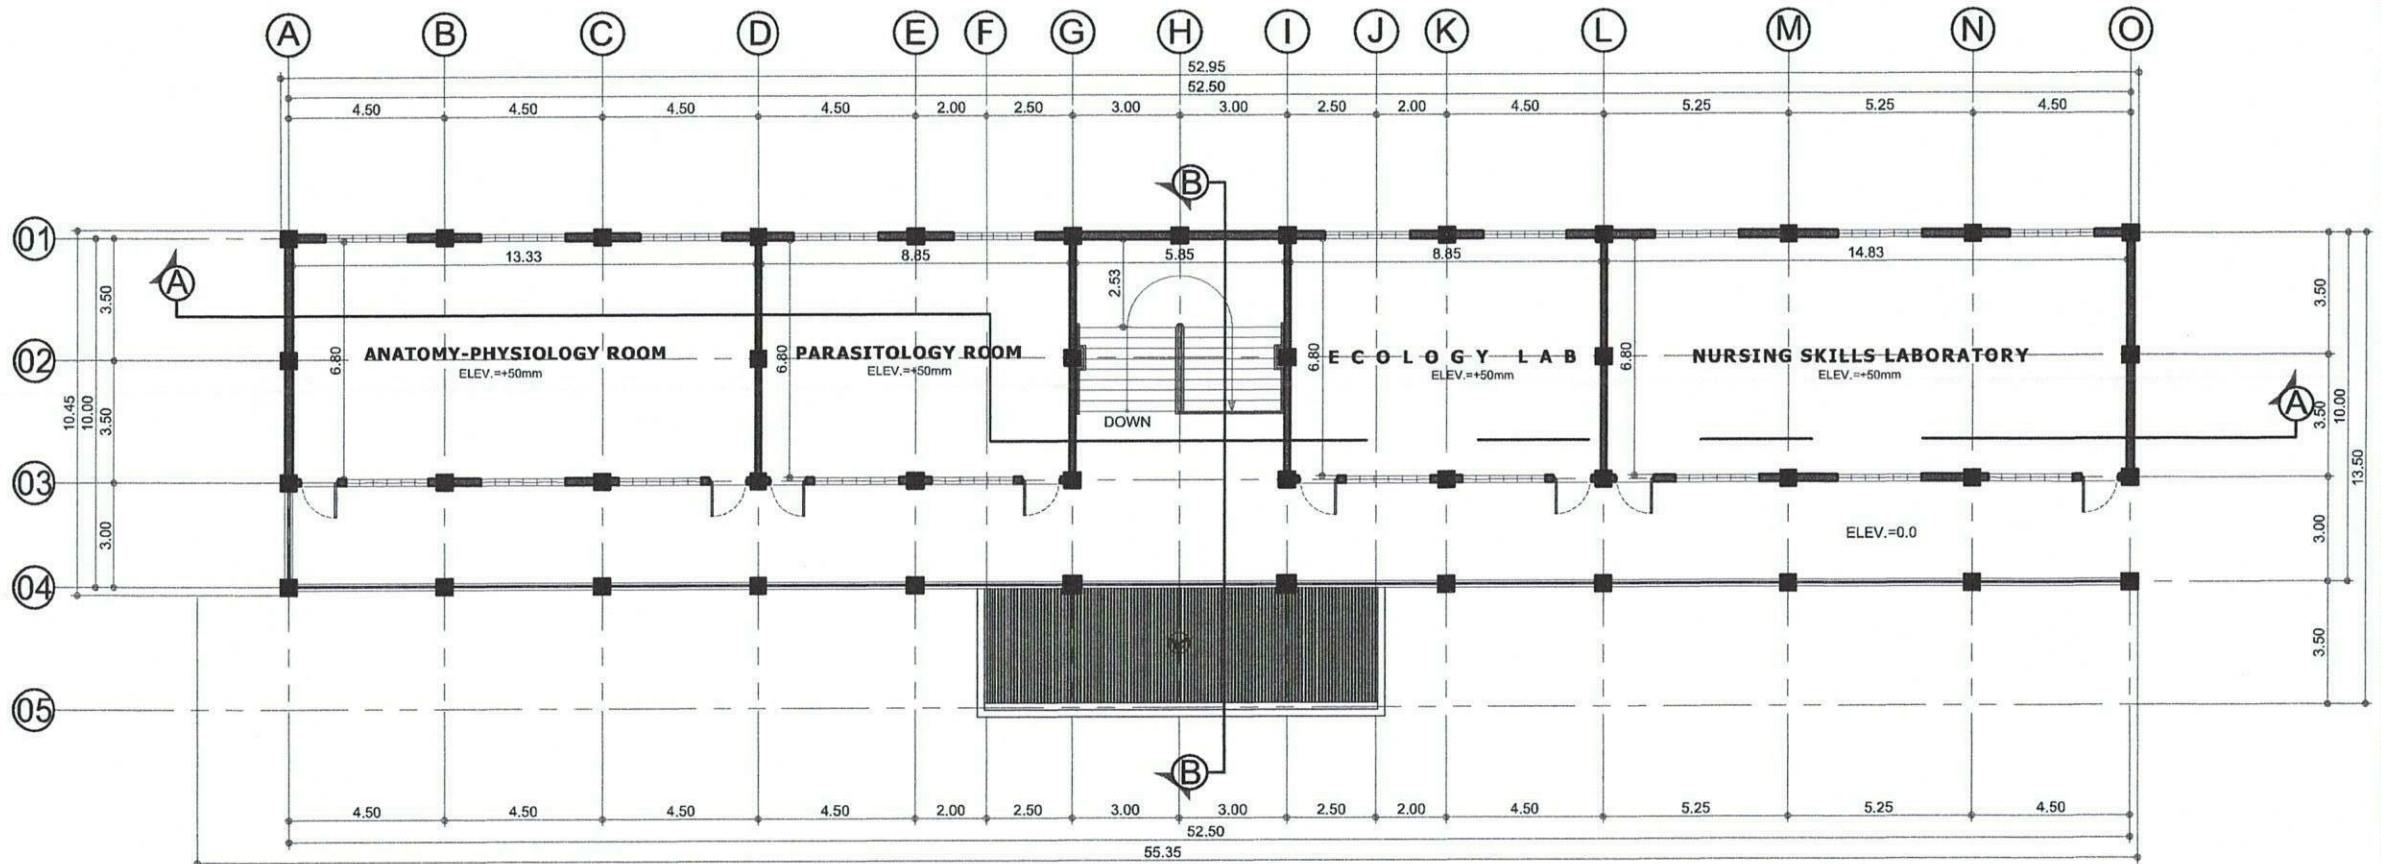


**A-04** **THIRD FLOOR PLAN**  
 01/01 SCALE 1:100 MTS.




PREPARED BY: DON HONORIO VENTURA STATE UNIVERSITY BACOLOR,PAMPANGA  OFFICE OF PHYSICAL PLANT AND FACILITIES	ARCHITECT :	PRC NO:	PROJECT TITLE :  <b>HEALTH &amp; SCIENCE BUILDING</b>	RECOMMENDING APPROVAL:  <u>ENGR. ROWEL WAJE Ma.Ed</u> <small>OIC-DIRECTOR, O.P.P.F</small>	APPROVED BY:  <u>ENRIQUE G. BAKING Ed.D</u> <small>SUC PRESIDENT III</small>	SHEET CONTENT:  AS SHOWN	CADD BY: R.V. MERCADO DATE / FILENAME :	SHEET NO. <b>A-03</b> <b>03/45</b>
		PTR NO: DATE: AT:						



**LEGEND:**

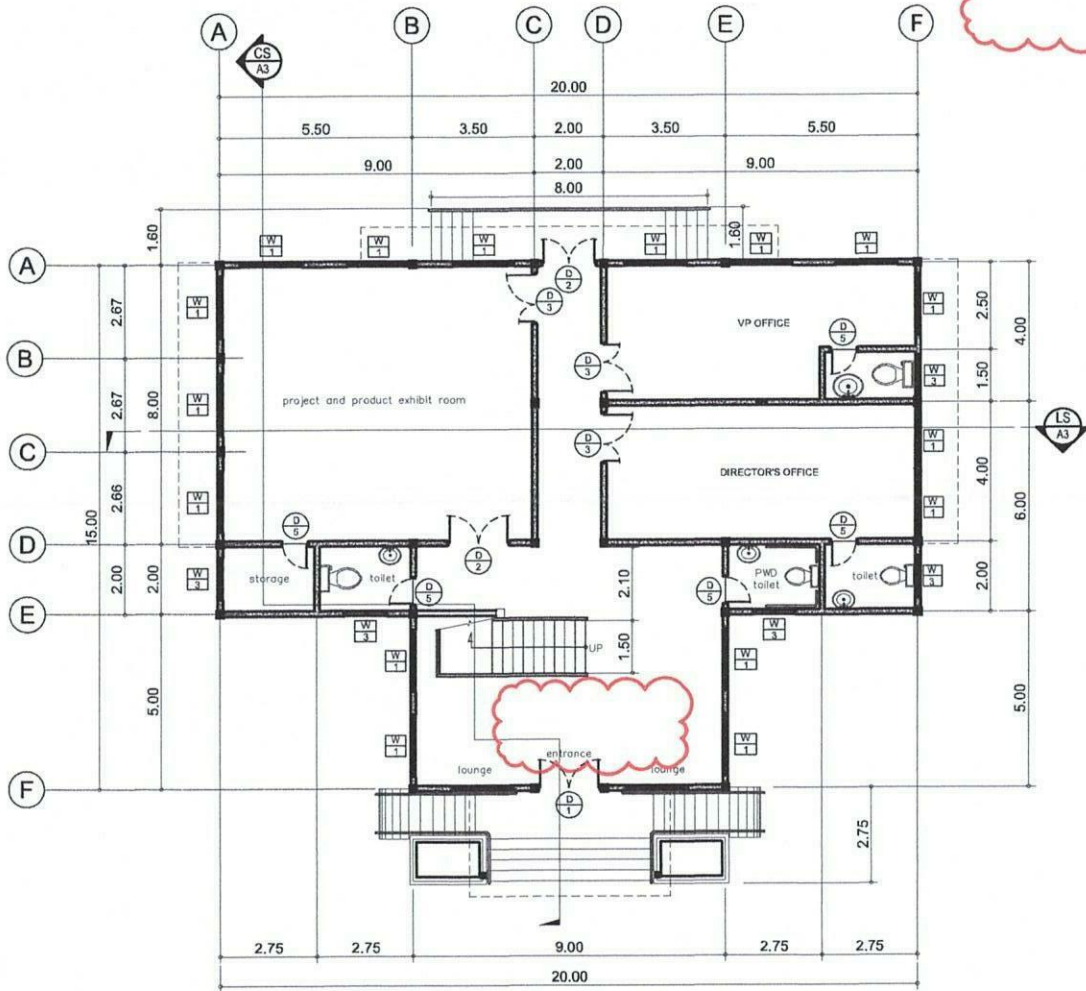

**A1**  
1/2  
**GROUND FLOOR PLAN**  
SCALE 1:100 MTS

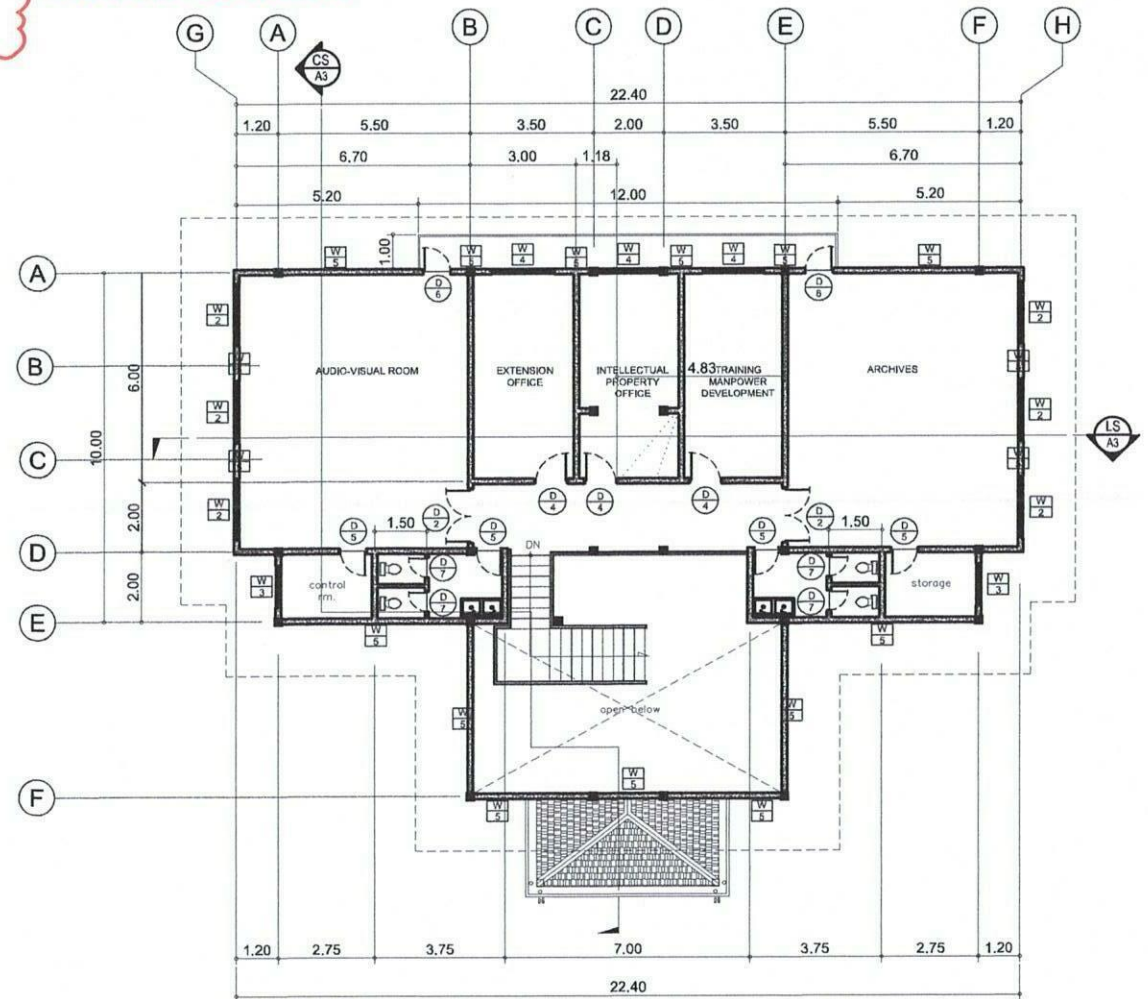

**A1**  
2/2  
**SECOND FLOOR PLAN**  
SCALE 1:100 MTS



PREPARED BY:  
DON HONORIO VENTURA STATE UNIVERSITY  
BACOLOR, PAMPANGA  
OFFICE of PHYSICAL PLANT and FACILITIES

ARCHITECT:  
PRC NO:  
TIN NO:  
PTR NO:  
DATE:  
AT:


PROJECT TITLE:  
**MULTI-DISCIPLINARY RESOURCES AND  
TOURISM CENTER AT MAIN CAMPUS**  
LOCATION:  
DHVSU, BACOLOR, PAMPANGA

**AS BUILT PLAN**


SHEET CONTENT:  
AS SHOWN  
DATE / FILENAME:

SHEET NO:  
**A1**  
101

**LEGEND:**

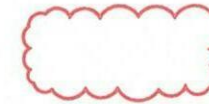

**DELIVERY LOCATION**

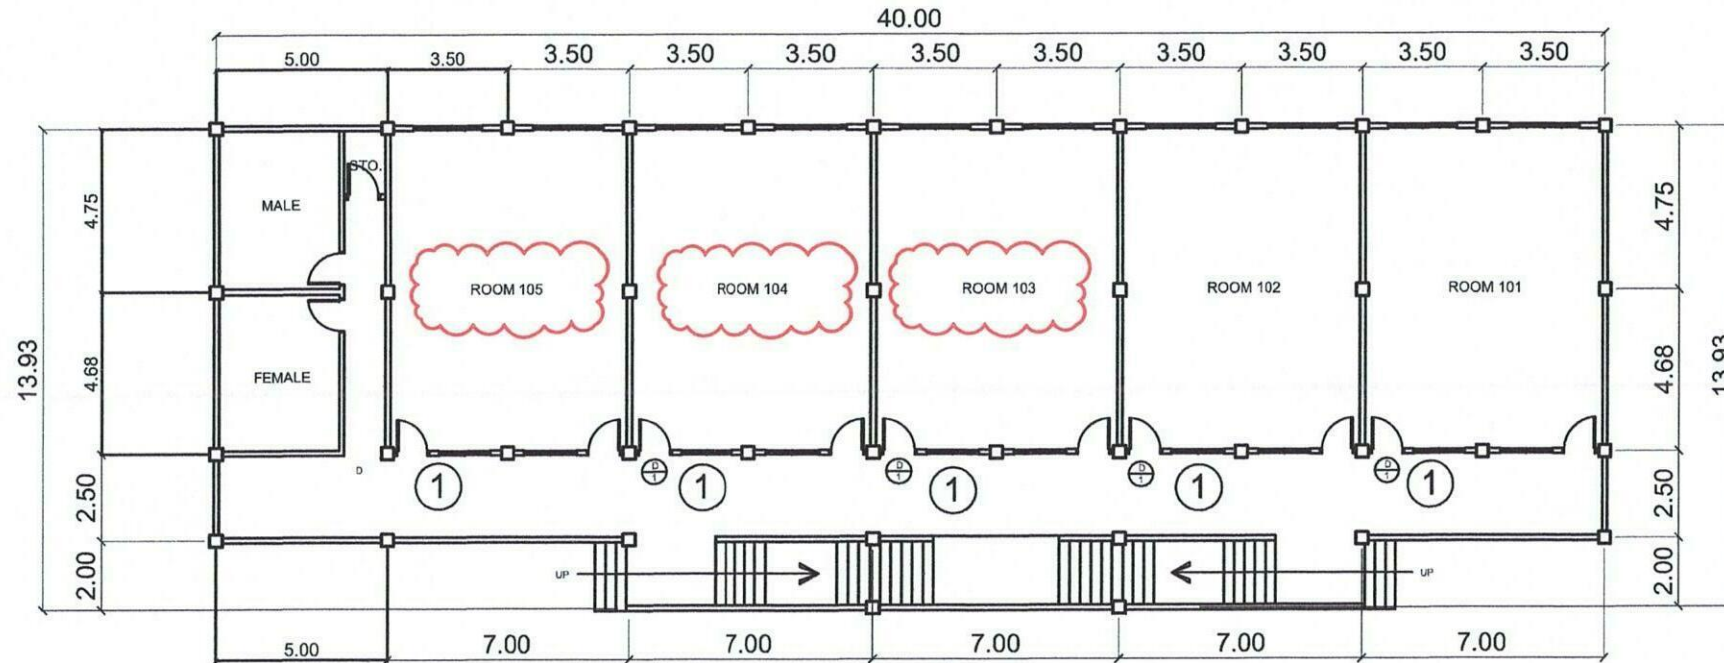

A-1  
01 02

**GROUND FLOOR PLAN**

SCALE


1 : 100 MTS.




PREPARED BY: DON HONORIO VENTURA STATE UNIVERSITY BACOLOR, PAMPANGA  OFFICE OF PHYSICAL PLANT AND FACILITIES	ARCHITECT	PRC NO.	PROJECT TITLE:  <b>COLLEGE OF COMPUTING STUDIES</b>	RECOMMENDING APPROVAL:	APPROVED BY:	SHEET CONTENT:	CADD BY:	SHEET NO.
		TIN NO.		ENGR. ROWEL WAJE Ma.Ed OIC-DIRECTOR, O.P.P.F	ENRIQUE G. BAKING Ed.D SUC PRESIDENT III	AS SHOWN	R.V. MERCADO	A-4 04 02
		PTR NO.				DATE / FILENAME:		
		DATE:		LOCATION:				
		AT:	PAMPANGA					



**LEGEND:**

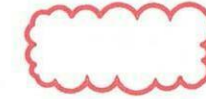

**DELIVERY LOCATION**

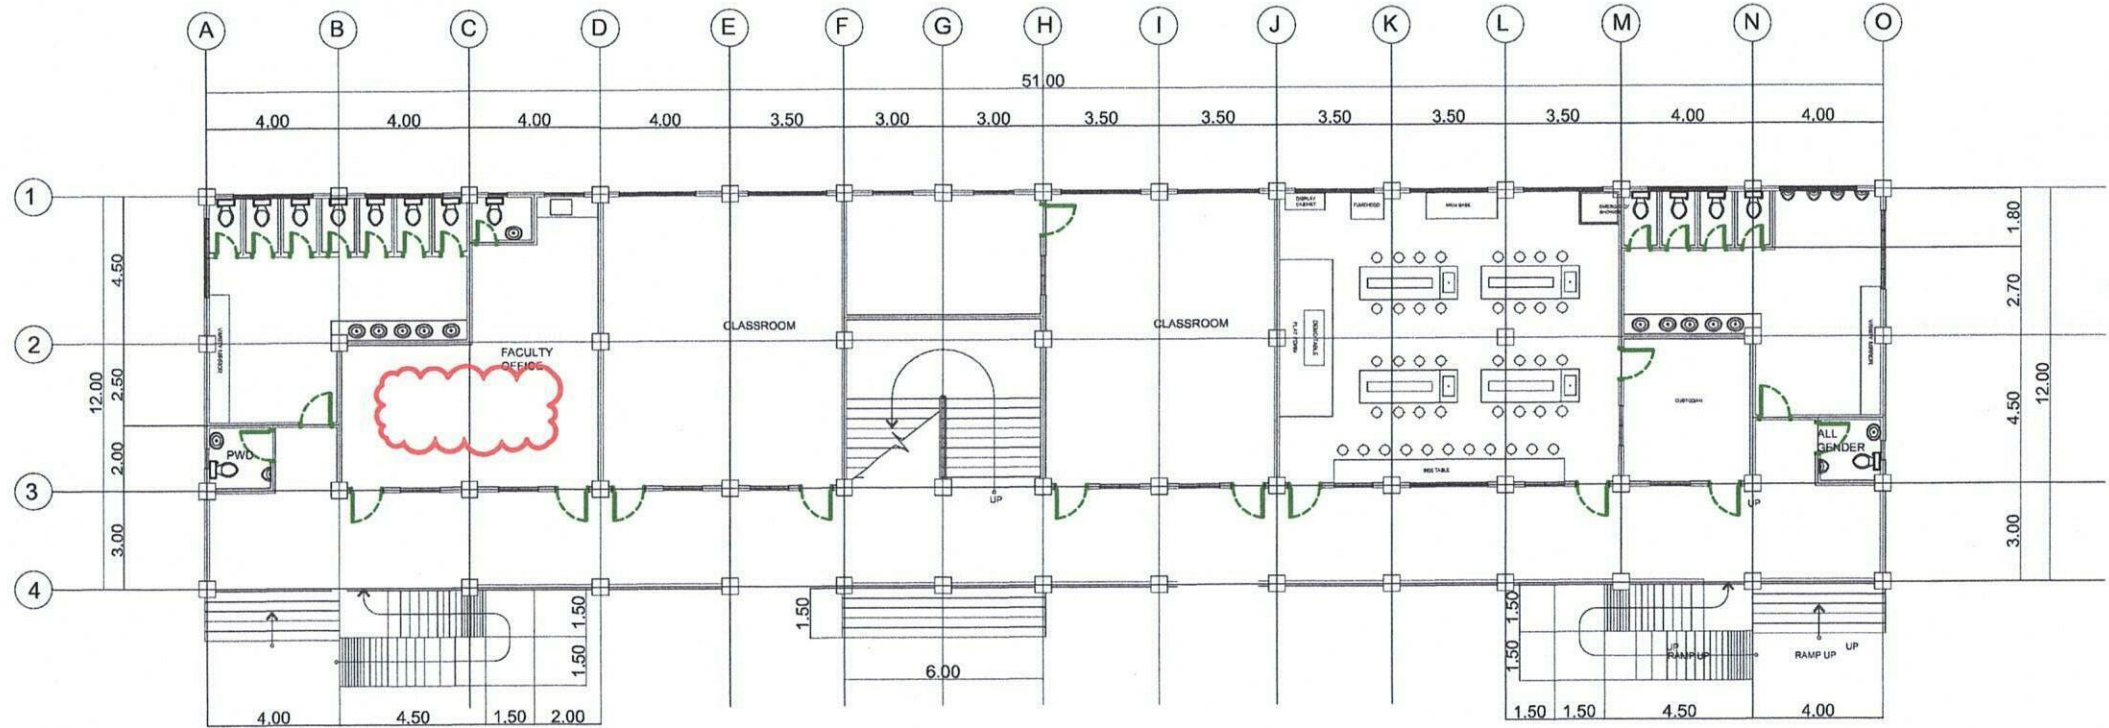

**GROUND FLOOR PLAN**

1:125 MTS.



DON HONORIO VENTURA STATE UNIVERSITY  
BAGUIO, PAMPANGA  
OFFICE OF PHYSICAL PLANT and FACILITIES

PROJECT TITLE  
**ACADEMIC BUILDING**

LOCATION:  
DHVSU, LUBAO, PAMPANGA

RECOMMENDING APPROVAL:  
**ENGR. ROWEL D. WAJE, MaED.**  
OPPF, DIRECTOR

APPROVED BY:  
**ENRIQUE G. BAKING Ed.D**  
SUC PRESIDENT III

PREPARED BY:  
**ROV F. TUNGCAB**  
INFRA - STAFF

SHEET NO.